



ADDENDUM NO. 4

DATE: April 23, 2024

TO: ALL PROSPECTIVE BIDDERS

SUBJECT: Solicitation No. AA018B

TITLE: Miami International Airport (MIA) South Terminal Concourse H Rehabilitation – Phase 1

This Addendum becomes a part of the subject solicitation.

A. **SUBMITTAL DATE** - The Solicitation End Date is April 25, 2024, at 2:00 PM Local Time.

B. **REVISIONS - DRAWINGS** – REFER TO ADDENDUM 4, ATTACHMENT 1

QUESTIONS & ANSWERS

Question No. 1 Answer to question #1 (in Addendum No. 3) that states “Refer to Addendum No.2, Revision C, detail G and H on Drawing (C) is hereby deleted and replaced with the following Answer: [Refer to Addendum No. 2, Drawing S1.07](#).”

Question No. 2 The curtain walls framing require a vertical tube steel column where the two curtain walls meet at the 90 degrees return to the building. The drawings have not designed, engineered, and sized these steel columns, they are not part of the curtain wall system. Please provide the engineering for these steel tube columns including all required top and bottom connection to the existing structure. Without this information we will not be able to include the cost of these steel columns in our bid.

[Answer No. 2:](#) [Refer to Addendum No 4, Attachment 1.](#)

All other information remains the same.

Miami-Dade County,

Claudia Portocarrero
Aviation Senior Procurement Contracting Officer


c: Clerk of the Board

ADDENDUM No. 4

ATTACHMENT 1 - Drawing


INSULATION
 STIFFENER
 METAL WALL PANEL

6
 A-78 **DETAIL**
 HALF SCALE

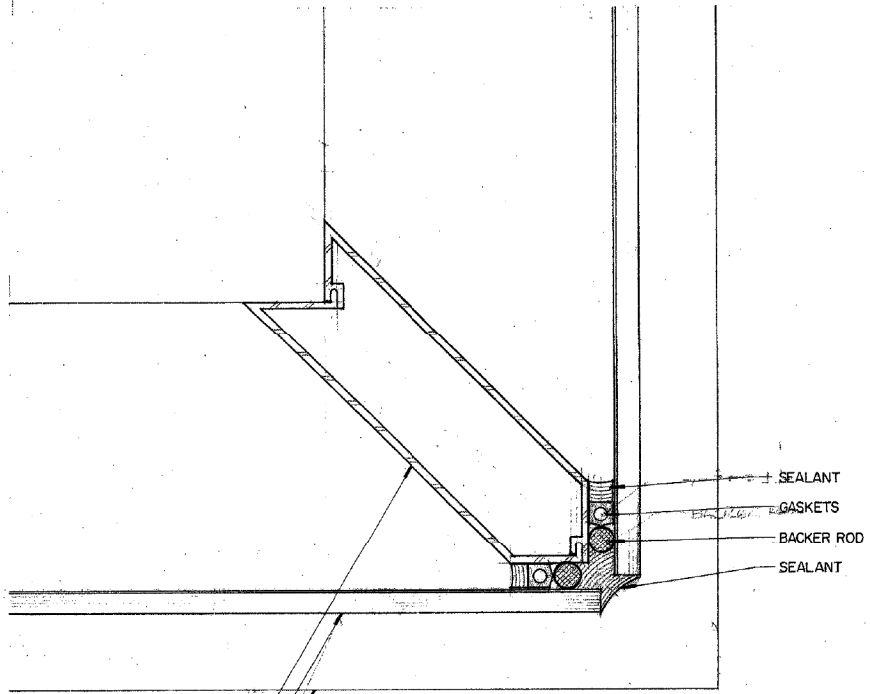


VERTICAL CORNER MULLION
 1/2" LAMINATED GLAZING
 SILL MULLION BELOW

10
 A-78 **DETAIL**
 HALF SCALE

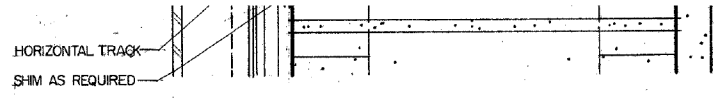

5
 A-78 **DETAIL**
 HALF SCALE

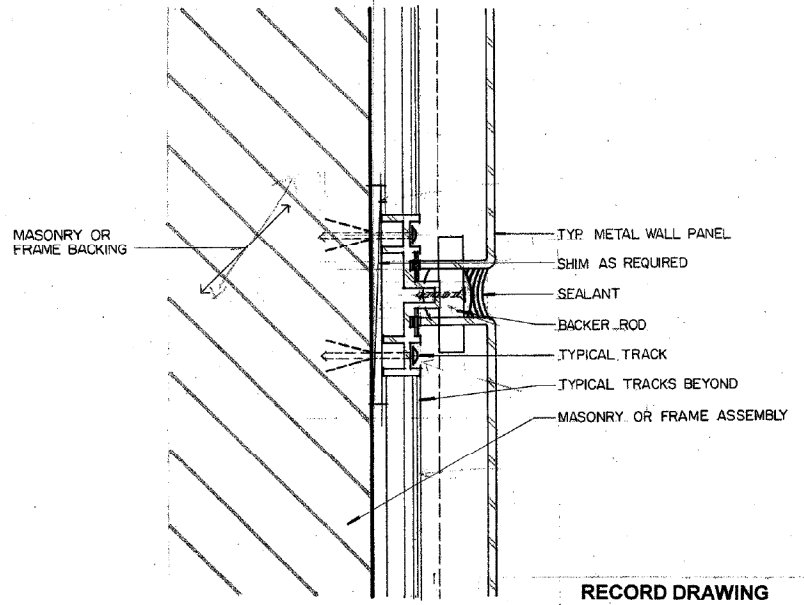

9
 A-78 **DETAIL**
 HALF SCALE

RECORD DRAWING

THIS DRAWING CONTAINS AS-BUILT INFORMATION RECORDED IN FIELD BY CENTEX ROONEY INC., GENERAL CONTRACTORS AS MARKED ON PRINTS OF CONSTRUCTION DRAWINGS UNDER D.C.A.D. CONTRACT 90038H32-1 BY PEREZ & PEREZ ARCHITECTS PLANNERS, INC.